


## LOCATION PLAN

CS1 SCALE: N.T.S.

**INTERIOR SIGNAGE AND GRAPHICS:**  
INTERIOR SIGNAGE AND GRAPHICS ARE BY OTHERS. REFER TO THE DESIGN COMPLIANCE PACKET (A.K.A. DCP) CREATED BY SELF ESTEEM BRANDS FOR THIS PROJECT, TO IDENTIFY LOCATIONS OF ALL INTERIOR BRAND SIGNAGE AND GRAPHICS. INTERIOR SIGNAGE IS BY 'DEFERRED SUBMITTAL', AS REFERENCED SEPARATELY ON THIS SHEET. CERTAIN SIGNAGE AND GRAPHICS ARE ALSO BY ANYTIME FITNESS VENDORS IDENTIFIED ON THE VENDOR SCHEDULE BELOW.

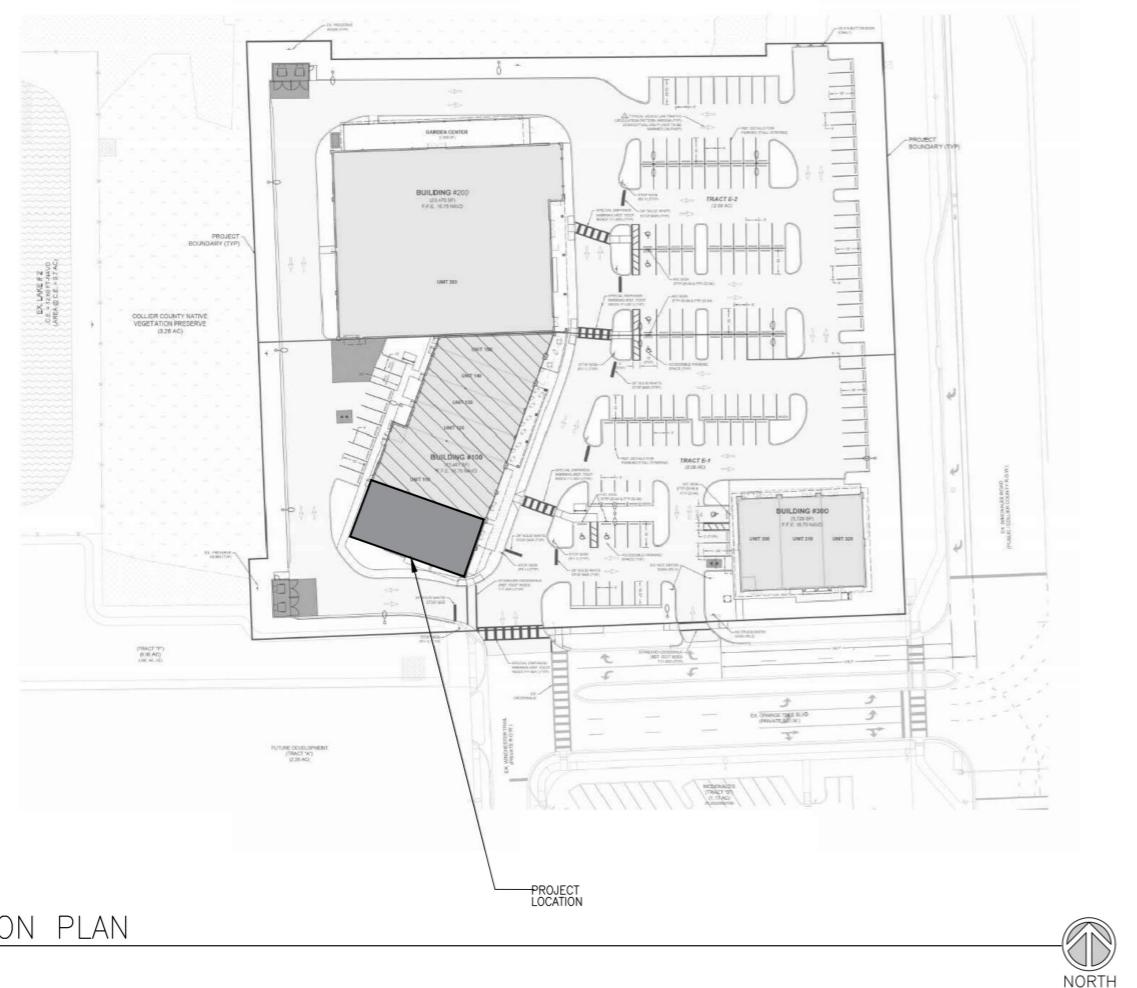

## DEFERRED SUBMITTALS:

1. FIRE SPRINKLER DRAWINGS
2. FIRE ALARM DRAWINGS
3. SIGNAGE DRAWINGS


## VENDOR SCHEDULE:

VENDOR	PRODUCT / SERVICE	CONTACT	PHONE/EMAIL
ARCHETYPE	INTERIOR SIGNAGE & GRAPHICS	JENNY KRUSE	(952) 641-9600 (JENNY) jenny@archetypesign.com customerservice@archetypesign.com
DALTILE	TILE		sebrands@daltile.com
DYSON	RESTROOM HAND DRYER	ADAM FINN	(312) 919-2077 adam.finn@dyson.com
ECORE INTERNATIONAL	RUBBER FLOORING (FREE WEIGHTS), TURF (FUNCTIONAL TRAINING), WALL PROTECTION (FREE WEIGHTS)	CUSTOMER SERVICE	(515) 450-2144 mbk@ecoreintl.com
GLOBAL RETAIL ENVIRONMENTS	MEMBER LOBBY - CUBBIES, LOCKABLE INSERTS & BENCHES MANAGER'S OFFICE - DESK LAMINATE SPACER FOR LIGHTBOX GUEST AND MEMBER LOBBY - CUSTOM DECORATIVE LIGHTING SOLID SURFACE SHOWER THRESHOLD	JOHN SCHARBER DENISE SCHARBER	(320) 983-0000 j.scharber@globalretailenvironments.com dscharber@globalretailenvironments.com
IKEA	CUBBIES FURNITURE		www.ikea.com/us/en
SEG SYSTEMS	LIGHTBOX	DAWN ARNOLD	TO ORDER CONTACT: dawn.arnold@segsystems.com (980) 380-9007
MAG RESOURCES	WINDOW SHADES	JASON GIOVANINI	(330) 419-8699 j2...giovanni@magresources.net
THE MIRROR COMPANY	MIRRORS (FREE WEIGHTS)		stacy@themirrorcompany.com (800) 473-0619 CUSTOMER SERVICE
PORTICO SYSTEMS	LVT	MIKE BEDFORD	(612) 209-4874 Mbedford@porticosystems.com
PROVISION SECURITY	SECURITY		(866) 315-0777 pprojectmanagers@provisionsecurity.com
SHAW INTEGRATED SOLUTIONS	CARPET & FLOORING	CUSTOMER SERVICE	(800) 338-9479 anytime.fitness@shawinc.com
SHERWIN WILLIAMS	PAINT	LOCAL STORE	NATIONAL ACCOUNT NUMBER: 5753-1214-5 FOR DISCOUNTED NATIONAL ACCOUNT PRICING
SPECIALTY LIGHTING	LIGHTING	NICK STEMM ALLISON GORA	(860) 767-0110 X 227, Nick.Stemm@SSLighting.com (860) 767-0110 X 239, Allison.Gora@SSLighting.com
TWIN CITY HARDWARE	DOORS, FRAMES & HARDWARE	BOB HAEN	(651) 731-7142 BOB, bhaen@tchco.com (651) 735-2200 CUSTOMER SERVICE
CONSTRUCTION SPECIALTIES	WALL PROTECTION (FREE WEIGHTS)	CUSTOMER CARE	nationalaccounts@c-sgroup.com

## ABBREVIATIONS:

ABV	ABOVE	EOS	EDGE OF SLAB	OC	ON CENTER
ACT	ACOUSTIC CEILING TILE	EP	ELECTRICAL PANEL	OD	OUTSIDE DIAMETER
AFF	ABOVE FINISHED FLOOR	EQ	EQUAL	OH	OVERHANG
ALUM	ALUMINUM	EQUIP	EQUIPMENT	OFCL	OWNER FURNISHED- CONTRACTOR INSTALLED
ANOD	ANODIZED	EXT	EXPANSION	OFD	OVERFLOW DRAIN
APPROX	APPROXIMATE	EXT	EXTERIOR	OFF	OFFICE
ARCH	ARCHITECT /ARCHITECTURAL	FD	FLOOR DRAIN OR FIRE DEPARTMENT	OPNG	OPENING
BTW	BETWEEN	FDN	FOUNDATION	PL	STEEL PLATE
CL	BACK OF CURB	FE	FLAME EXTINGUISHER	PNT	PAINT OR PAINTED
CLG	BOARD	FG	FINISHED FLOOR	PR	PAIR
CLOS	BUILDING	FG	FINISHED GRADE		
CLR	BEAM	FIN	FINISH	R	RADIUS
CMU	CONCRETE BLOCK UNIT	FL	FINISHED SURFACE	REV	REVISION
CO	CLEAR OPENING	FRP	FINISH REINFORCED PANEL	REQD	REQUIRED
COL	COLUMN	FT	FINISHED SURFACE	ROOM	ROOM
CORR	CORRIDOR	FV	FEET/FOOT	SC	SEALED CONCRETE SHEET
CONN	CONCRETE	GWB	FIELD VERIFY	SHT	SIMILAR
CONT	CONTINUOUS	GLAZ	GYPSUM WALL BOARD	SIM	SPECIFICATIONS
CPT	CARPET	GC	GENERAL CONTRACTOR	SS	STAINLESS STEEL
CT	CERAMIC TILE	HC	HANDICAPPED	STD	STEEL
DET	DETAIL	HR	HOUR	SQ	SQUARE
DF	DRINKING FOUNTAIN	HT	HEIGHT	T	TREADS
DIA	DIAMETER	INSUL	INSULATION	TC	TOP OF CURB
DIM	DIMENSION	INT	INTERIOR	TGC	TENANT GENERAL CONTRACTOR
DN	DOWN	INFO	INFORMATION		
DR	DOOR	TEL	TELEPHONE		
DWG	DRAWING	JT	TO		
EA	EACH	LNDG	TOP OF		
EL	ELEVATION	LO	TOP OF SLAB		
ELEV	ELEVATOR	MAX	TOP OF WALL		
ELEC	ELECTRICAL	MECH	TOP OF STEEL		
ELEV	ELEVATOR OR	MFR	TOPICAL		
EPDM	ELEVATION ETHYLENE PROPYLENE DIENE M-CLASS (ROOFING)	MIN	VCT		
		MISC	VINYL COMPOSITION TILE		
		MO	VERIFICATION IN FIELD		
		NA	W/		
		NIC	WOOD		
		NO	WATER CLOSET		
		NTS	WATER HEATER		
			WITHOUT		

## DRAWING LEGEND:

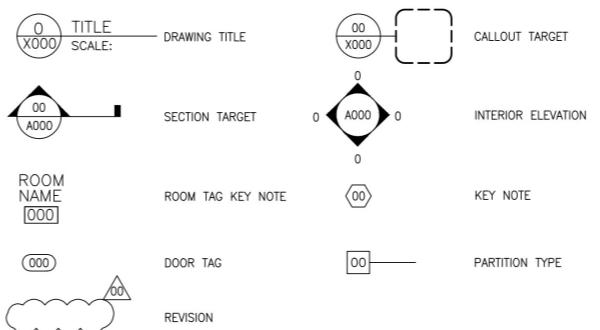

AF #5385 SCHEME: REAL AF



WINCHESTER CENTER  
BUILDING 100 SUITE 100  
NAPLES, FL 34120

## PROJECT DIRECTORY:

ARCHITECT:



1515 DES PERES ROAD  
SUITE 200  
ST. LOUIS, MO 63131

DAVID MACHICAO  
MANAGING ARCHITECT  
314-997-6111  
d.machicao@trileaf.com

ENGINEER:




1515 DES PERES ROAD  
SUITE 200  
ST. LOUIS, MO 63131  
MARK KUHLMAN  
314-997-6111  
m.kulhman@trileaf.com

CONSTRUCTION  
DESIGN MANAGER:



ANYTIME FITNESS  
111 WEIR DRIVE  
WOODBURY, MN 55125  
JULIE BUSCH  
612-426-6070  
julie.busch@sebrands.com

SELF ESTEEM

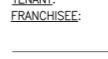


AF ORANGETREE, LLC  
13851 WINCHESTER TRAIL  
NAPLES, FL 34120  
CHRISTOPHER JUAREZ  
708-692-7009  
n Naplesfitnesspro@gmail.com

TENANT:  
FRANCHISEE:



BCHD PARTNERS I, LLC  
C/O METRO COMMERCIAL  
2950 SW 27TH AVE.  
MIAMI, FL 33133  
KALAYAH SARGEANT  
954-279-6847  
ksargeant@metrocommercial.com

PROPERTY OWNER:

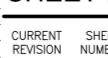

STATE OF FLORIDA  
DAVID CHARLES MACHICAO  
— ★ —  
AR103484  
26/11/25

## SHEET INDEX:

CURRENT REVISION	NUMBER	NAME
CS1		Cover Sheet
		Code Sheet
		General Notes
		Accessibility Requirements
		Architectural Floor Plan
		Enlarged Toilet Room Plan & Elevations
		Generic Restroom Tile Details (for Contractors Reference)
		Finish Plan
		Schedules
		Reflected Ceiling Plan
		Partition Types
		Office Details
		Details
		Details
		Specifications
		Specifications
		Mechanical General Notes and Specifications
		Hvac Floor Plan
		Hvac Details
		Hvac Schedules
		Electrical Legend, Notes & Abbreviations
		Electrical Floor Plan
		Electrical Lighting Plan
		Electrical Details and Schedules
		Plumbing General Notes and Specifications
		Plumbing Floor Plans and Riser Diagrams
		Plumbing Details and Schedules

David  
Machicao  
Digitally signed by  
David Machicao  
Date: 2025.06.11  
14:35:38 -05'00'



WINCHESTER CENTER  
13851 WINCHESTER TRAIL  
NAPLES, FL 34120

## REVISIONS

REV.	DATE	ISSUE
	06/11/25	REVISION

DATE: 05.27.25

DRAWN BY: AAB

CHECKED BY: DM

PROJECT NUMBER: 756368

## COVER SHEET

CS1






Boot Tray Transition	14.1 FT
River Cobble	18.3 SQ FT
1.5" x 1.5" Aluminum Edging	14.1 FT
Floor Transition	3.0 FT
LVT-1	1406.6 SQ FT
SC-1	106.9 SQ FT
TURF	453.3 SQ FT
RF	1258.5 SQ FT
T-2	147.2 SQ FT
Waterproof Membrane	147.2 SQ FT
Provide Mirrors Along the Face of the Wall	6.0 EA
Transition Strip	73.8 FT
8'-0" High FRP Wainscot	13.1 FT
"VB-1" Vinyl Wall Base	285.5 FT
T-2 Tile Base	61.8 FT
Schluter Schiene	61.8 FT
WP-1 (12'-0")	54.8 FT
WP-2 (12'-0")	38.1 FT
PN-1 (12'-0")	105.8 FT
PN-3 (12'-0")	55.8 FT
PN-1 (3'-0")	59.4 FT
PN-4 (9'-0")	4.0 FT
PN-4 (2'-7")	20.8 FT
PN-1 (10'-0")	50.6 FT
PN-4 (10'-0")	3.9 FT
PN-2 (10'-0")	17.0 FT
PN-2 (12'-0")	52.4 FT
PN-4 (12'-0")	34.1 FT
PN-1 (9'-0")	23.3 FT
PN-6 (9'-0")	9.3 FT
T-3 (4'-6")	63.9 FT
PN-5 (4'-6")	50.6 FT
PN-7 (4'-6")	16.0 FT
T-3 (9'-0")	9.3 FT
Schluter Schiene Trim (9'-0")	5.0 EA
Miter Schluter Trim (4'-6")	13.0 EA

FINISHES AT FEATURE WALL

SCALE: 1" = 1'-0"

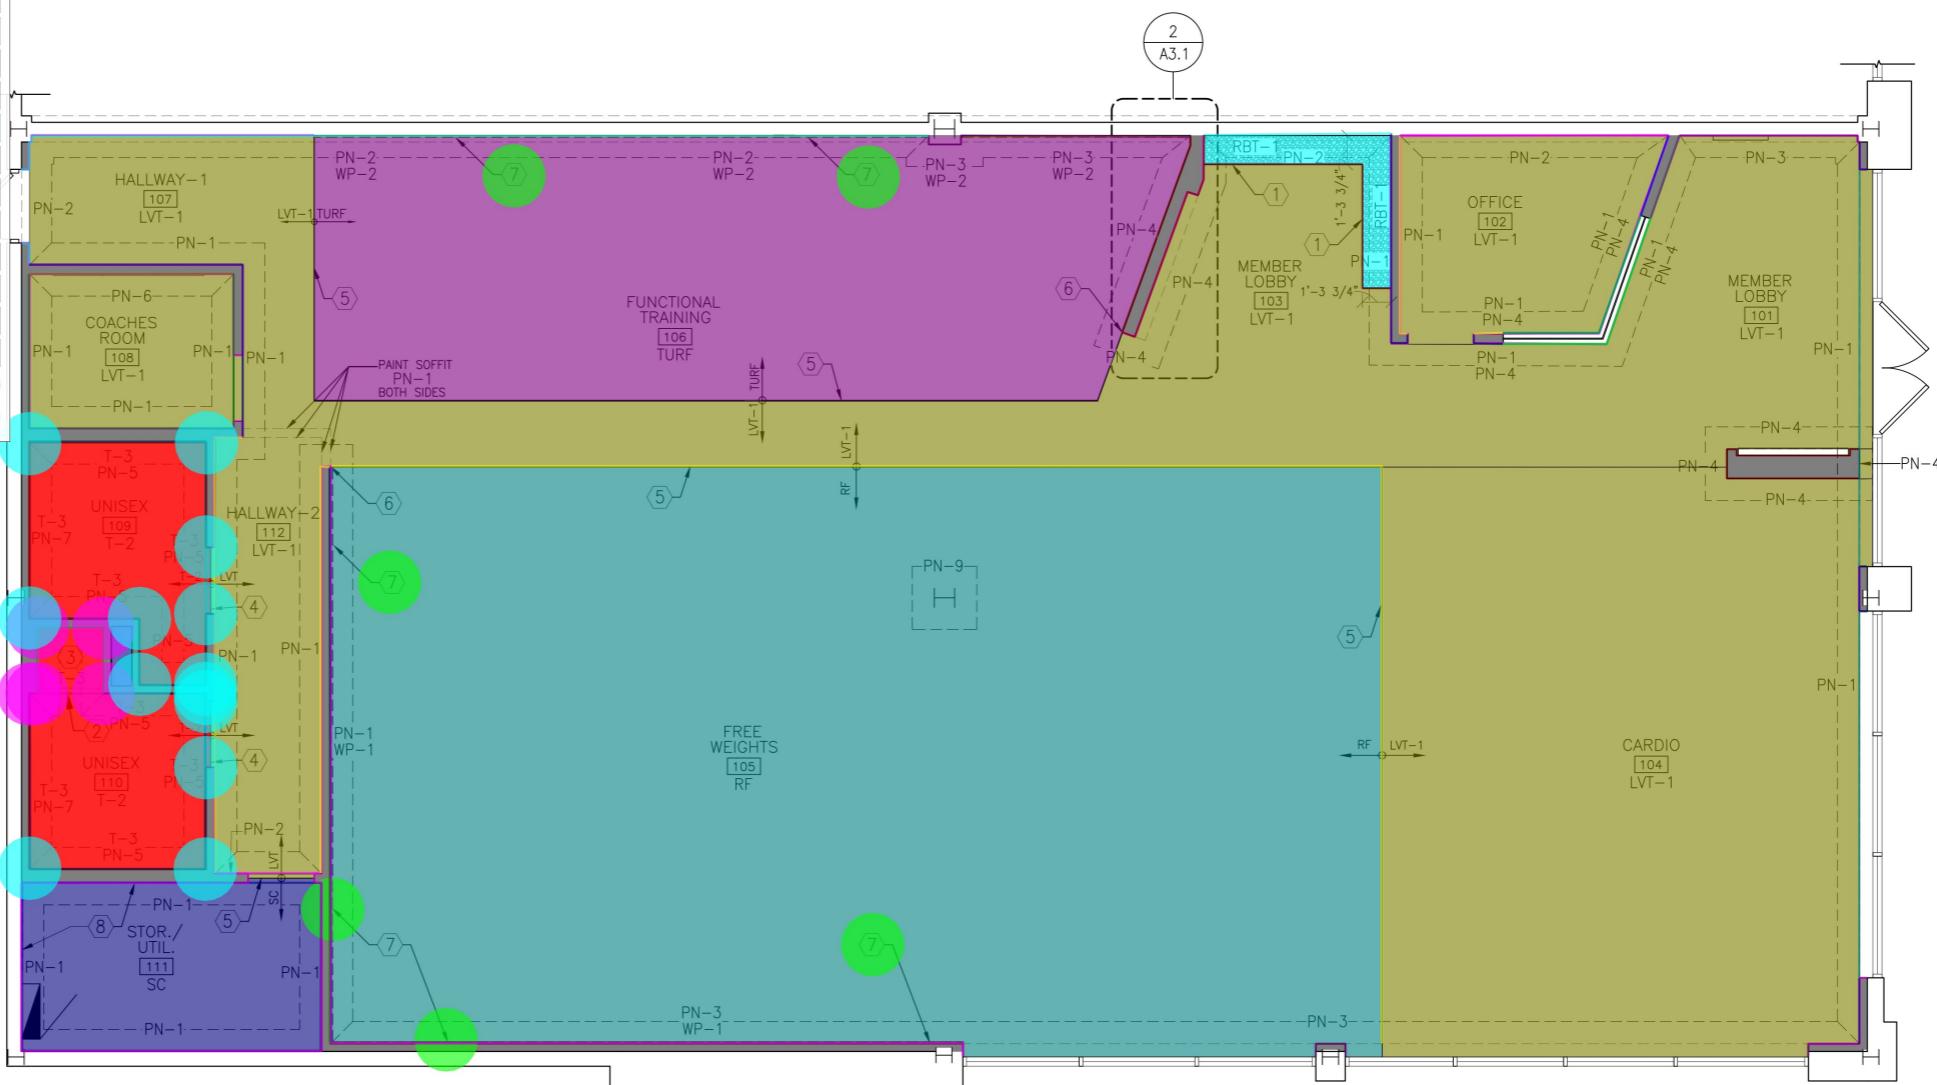

1 FINISH PLAN  
A3.1  
SCALE: 1/4" = 1'-0"

#### KEYED NOTES:

- ① BOOT TRAY TRANSITION WITH RIVER ROCK ON FLOOR BELOW CUBBIES. REFER TO DETAIL 6/A6.2, 7/A6.2 AND 14/A6.2.
- ② FLOOR TRANSITION AT SHOWER - REFER TO DETAIL 3/A2.2.
- ③ TILE (T-4) AT SHOWER FLOOR - TYPICAL.
- ④ FLOOR TRANSITION STRIP - REFER DETAIL 8/A6.3.
- ⑤ FLOOR TRANSITION STRIP - REFER TO DETAIL 9/A6.3.
- ⑥ ALIGN FLOORING TRANSITION AT CORNER OF WALL.
- ⑦ PROVIDE MIRRORS ALONG FACE OF WALL AS INDICATED. FROM 2'-0" A.F.F. TO 8'-0" A.F.F. LAMINATE DIRECTLY TO WALL SURFACE.
- ⑧ PROVIDE 8'-0" HIGH FRP WAINSCOT AT BACK WALL OF SERVICE SINK AND WATER HEATER AS SHOWN.

#### ARCHITECT



architecture | engineering  
1515 DES PERES ROAD, STE 200  
SAINT LOUIS, MISSOURI 63131  
PHONE | 314-997-6111 FAX | 314-997-8066

#### CONSULTANT

#### SEAL



**ANYTIME** **FITNESS**  
WINCHESTER CENTER  
13851 WINCHESTER TRAIL  
NAPLES, FL 34120

#### REVISIONS

REV.	DATE	ISSUE

DATE: 05.27.25  
DRAWN BY: XXX  
CHECKED BY: DM  
PROJECT NUMBER: 756368

#### FINISH PLAN

A3.1




KEYED NOTES:

- (2x2) Suspended Acoustic Ceiling & Grid
- 5/8" Type X MR Gypsum Board Ceiling
- 6" Metal Joist 20 GA @ 24" O.C.
- Paint "PN-9"
- Paint "PN-10" @ Exposed Structure


REFLECTED CEILING LEGEND:

NEW 2' x 2' LED FIXTURE	256.3 SQ FT
WHITE CEILING FAN—ENVIRONFAN—SILVER LINE 48F-9	145.6 SQ FT
PAINT CONDUIT TO MOTOR PRIOR TO INSTALLATION	145.6 SQ FT
RECESSED 4" LED, DOWN LIGHT FIXTURE	145.6 SQ FT
5 3/4" x 4" LED, STRIP LIGHT FIXTURE	145.6 SQ FT
RECESSED 4" LED, DOWN LIGHT FIXTURE	2928.7 SQ FT
7-5/8" x 48" SUSPENDED LED FIXTURE	
2 1/2" x 8" LED FIXTURE	
2 1/2" x 4" LED FIXTURE	

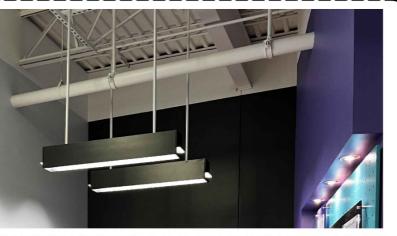


CEILING PHOTOS  
N.T.S.

GC TO VERIFY ALL EXISTING  
CONDITIONS. DESCRIPTIVE  
TO BE REPORTED TO  
ARCHITECT PRIOR TO  
STARTING CONSTRUCTION.

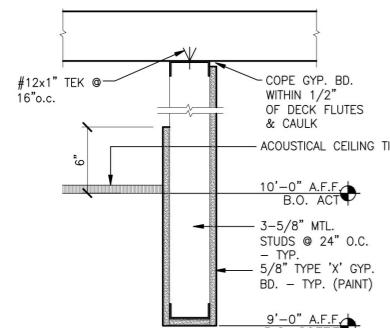

**BULKHEAD DETAIL**

SCALE: 1 1/2" = 1'-0"

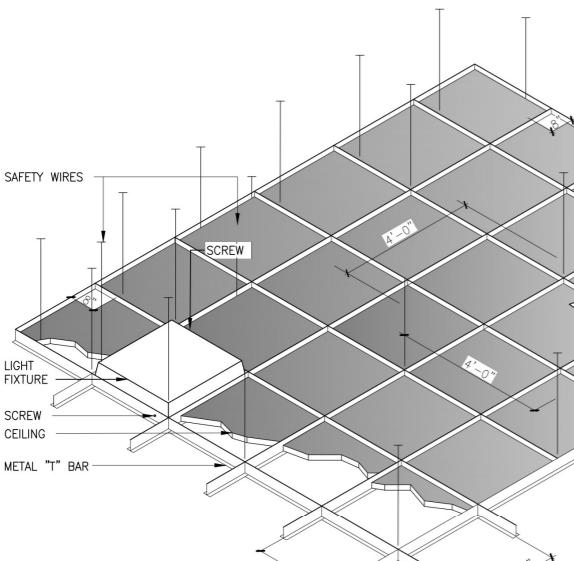

**SUSPENDED CEILING NOTES:**

1. ALL HANGER & BRACING WIRES SHALL BE SECURED TO MAIN RUNNERS.
2. PROVIDE TRAPEZE OF OTHER SUPPLEMENTARY SUPPORT MEMBERS AT OBSTRUCTIONS TO MAIN HANGER SPACING. PROVIDE ADDITIONAL HANGERS, STRUTS OR BRACES AS REQUIRED AT ALL CEILING BREAKS, SOFFITS OR DISCONTINUOUS AREA. HANGER WIRES THAT ARE MORE THAN 1 IN 6 OUT OF PLUMB ARE TO HAVE COUNTER SLOPING WIRES.


**MAIN SUPPORTS:**  
12 GAUGE HANGER WIRES AT 4'-0" EACH WAY.

**PERIMETER WIRES:**  
12 GAUGE PERIMETER WIRES INSTALLED WITHIN 8" OF WALL AT EACH MAIN AND CROSS TEE TO WALL JUNCTURE.

**LIGHT FIXTURE SUPPORT:**  
12 GAUGE WIRES ATTACHED TO MAIN OR CROSS TEES WITHIN 3" OF FIXTURE AT EACH CORNER. 12 GAUGE SAFETY WIRES ATTACHED TO FIXTURE (OPPOSITE CORNERS), EXTENDING TO STRUCTURE ABOVE. INSTALL ON SCREW AT OPPOSITE CORNERS OF FIXTURE TO MAIN OR CROSS TEES.

**SUSPENDED CEILING DETAIL**

A4.1  
NTS

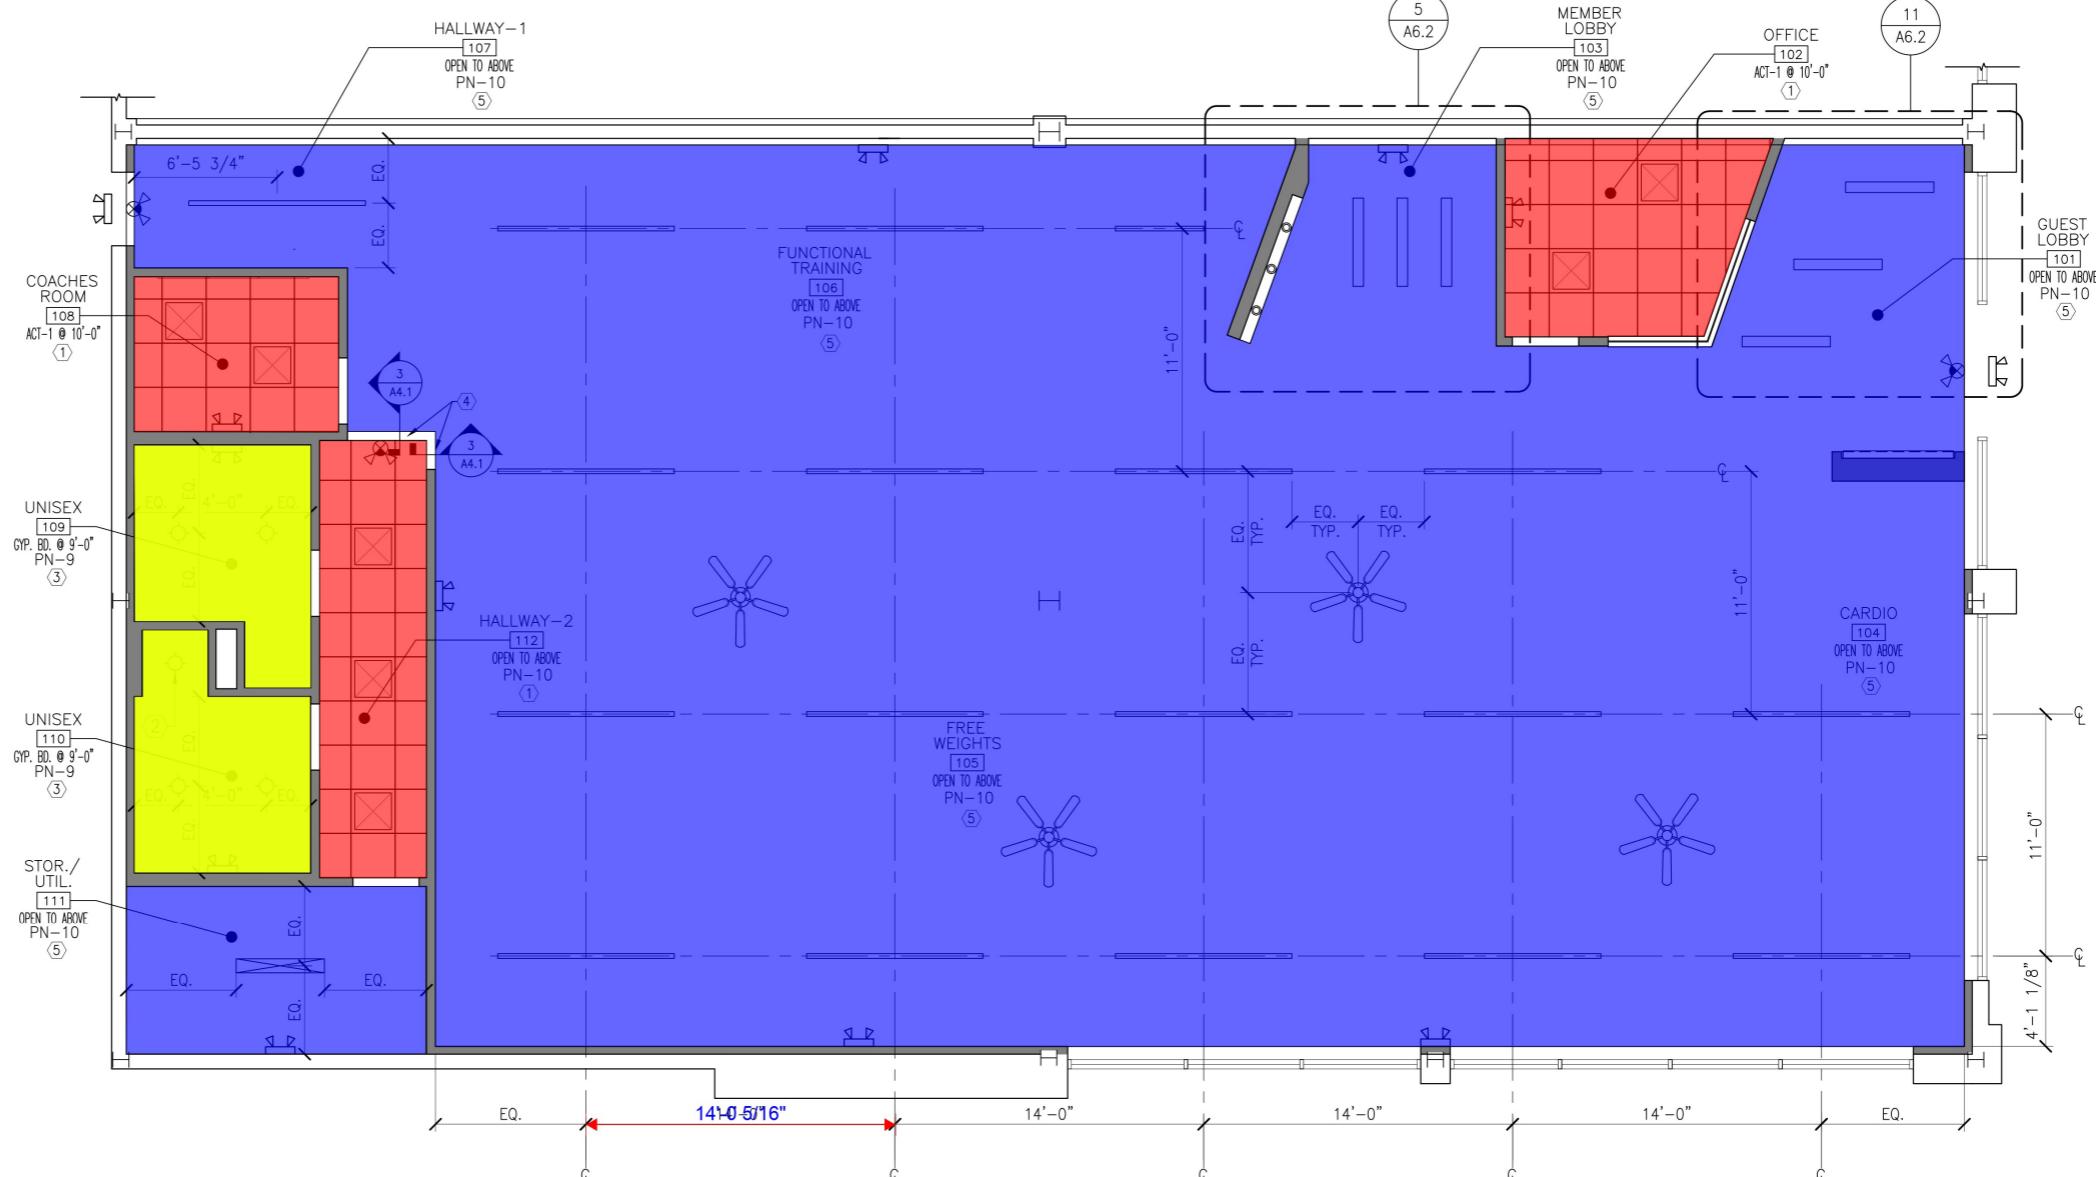

**REFLECTED CEILING PLAN**

A4.1  
SCALE: 1/4" = 1'-0"



ARCHITECT

**TRILEAF**  
architecture | engineering  
1515 DES PERES ROAD, STE 200  
SAINT LOUIS, MISSOURI 63131  
PHONE | 314-997-6111 FAX | 314-997-8066

CONSULTANT

SEAL



**ANYTIME FITNESS**  
WINCHESTER CENTER  
13851 WINCHESTER TRAIL  
NAPLES, FL 34120

REVISIONS

REV. DATE ISSUE

DATE: 05.27.25

DRAWN BY: AAB

CHECKED BY: DM

PROJECT NUMBER: 756368

REFLECTED  
CEILING PLAN

A4.1

(6x6) Duct	34.7 FT
(8x8) Duct	38.1 FT
(6" Dia.) Circular Duct	14.5 FT
(10" Dia.) Circular Duct	9.3 FT
(22" Dia.) Circular Duct	5.5 FT
(18" Dia.) Circular Duct	13.7 FT
(14" Dia.) Circular Duct	13.3 FT
(6" Dia.) Insulated Flexible Duct	12.0 FT
RTU-1	1.0 EA
RTU-2	1.0 EA
"EF-1"	1.0 EA
"EF-2"	1.0 EA
"EF-3"	1.0 EA
Supply Grille "A" 300 CFM	3.0 EA
Supply Grille "A" 500 CFM	3.0 EA
Supply Grille "B" 50 CFM	2.0 EA
Supply Grille "B" 150 CFM	2.0 EA
Return Grille "C" 150 CFM	2.0 EA
Return Sidewall Grille "D" 150 CFM	2.0 EA
Supply Sidewall Grille "E" 125 CFM	1.0 EA
Supply Sidewall Grille "E" 100 CFM	1.0 EA
New Curb Adapter	2.0 EA
Plenum Box	2.0 EA
Duct Smoke Detector	1.0 EA
Exhaust Air Vent Wall Cap	7.0 EA
Duct Transition	7.0 EA
New (48x48) Concentric Diffuser	1.0 EA
(30x14) Return Ductwork	1.0 EA
Thermostat	2.0 EA
Single Blade Balancing Damper	5.0 EA
Seal Joint	5.0 EA
Spin Collar	5.0 EA
Nylon Strap	4.0 EA
Backdraft Damper	3.0 EA
6" Fiberglass Insulation	67.2 SQ FT
Counter Flashing	47.6 FT
Volume Damper	2.0 EA
Bird Screen	2.0 EA
MERV 8 Filters	2.0 EA

#### KEY NOTES:

- DUCT MOUNTED SIDEWALL DIFFUSERS SHALL BE POSITIONED SUCH THAT THE DISCHARGE AIR DOES NOT DISCHARGE DIRECTLY ONTO A LIGHT FIXTURE AND CAUSE SWAYING.
- NEW ROOFTOP UNIT ON ROOF INSTALLED ON EXISTING CURB. PROVIDE NEW CURB ADAPTER AS REQUIRED. EXTEND PROVIDE NEW SUPPLY/RETURN PLENUM BOX FROM UNIT, MATCH SIZE OF INLET/DISCHARGE, CONFIRM EXACT SIZE WITH FINAL EQUIPMENT SUBMITTALS.
- PROVIDE NEW DUCT SMOKE DETECTOR UPSTREAM OF ALL DUCT CONNECTIONS TO PLENUM BOX.
- PROVIDE NEW EXHAUST AIR VENT WALL CAP.
- PROVIDE NEW 48x48 CONCENTRIC DIFFUSER EQUIVALENT TO TITUS CSR-P.
- COORDINATE INLET / DISCHARGE DUCTWORK WITH NEW WALL THAT EXTENDS TO DECK. OFFSET DUCTWORK IN CURB AS REQUIRED.
- CONNECT NEW 30x14 RETURN DUCTWORK TO EXISTING INTAKE PLENUM. PROVIDE DOUBLE ELBOWS SUCH THAT THE INLET IS FACING THE ROOF DECK. COVER OPENING WITH HARDWARE CLOTH. PROVIDE INTERNAL INSULATION ON RETURN DUCT FOR NOISE ABATEMENT.

#### ARCHITECT



architecture | engineering  
1515 DES PERES ROAD, STE 200  
SAINT LOUIS, MISSOURI 63131  
PHONE | 314-997-8011 FAX | 314-997-8086

#### CONSULTANT

#### SEAL

KYLE J. DAVIS  
LIC# 84275  
STATE OF FLORIDA  
PROFESSIONAL ENGINEER  
THIS DRAWING HAS BEEN ELECTRONICALLY SIGNED AND SEALED BY  
KYLE J. DAVIS. COPIES OF THIS DOCUMENT ARE NOT  
CONSIDERED SIGNED AND SEALED UNLESS THE SIGNATURE MUST  
BE PRESENT ON THE DRAWING.



WINCHESTER CENTER  
13851 WINCHESTER TRAIL  
BUILDING 100 SUITE 100  
NAPLES, FL 34120

#### REVISIONS

REV.	DATE	ISSUE
1	06/11/25	REVISION 1

DATE: 05.27.25  
DRAWN BY: KJD  
CHECKED BY: KJD  
PROJECT NUMBER: 756368


#### HVAC FLOOR PLAN

M2



1 HVAC FLOOR PLAN  
M2  
SCALE: 1/4" = 1'-0"




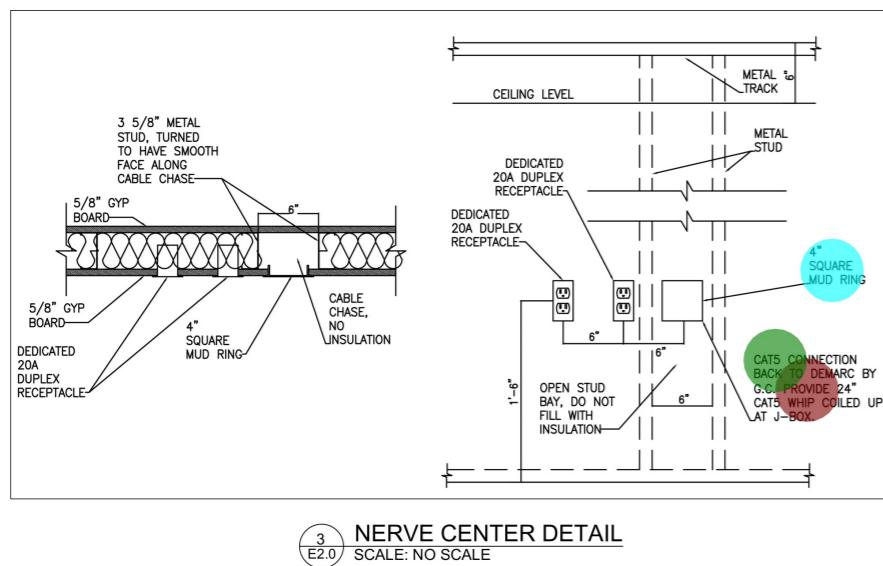

3  
E2.0 NERVE CENTER DETAIL  
SCALE: NO SCALE

## GENERAL NOTES

<p>A. ALL DIMENSIONS AND CONDITIONS TO BE PROVIDED BY CONTRACTOR OR TRADES INVOLVED PRIOR TO BIDDING AND CONSTRUCTION REPORT AND DISCREPANCIES TO/WITH ARCHITECT PRIOR TO WORK.</p>	<p>Light Box UTILIZE EXISTING 800A, 120/208V, 3PH/4W PANELBOARD "A" FOR ALL LIGHTING AND POWER REQUIREMENTS. PROVIDE NEW CIRCUIT BREAKERS AS SHOWN ON DRAWING E4.0.</p>	<p>8. PROVIDE POWER CONNECTION AND LOCAL DISCONNECTING MEANS TO RECIRCULATION PUMP. COORDINATE WITH M.C.</p>
<p>B. THE ELECTRICAL CONTRACTOR IS RESPONSIBLE FOR ALL EQUIPMENT, OPERATIONS, METHODS, LABOR, DEMOLITION AND CONSTRUCTION REQUIREMENTS FOR THE FINISHED CONDITIONS DESCRIBED IN THESE NOTED OTHERWISE. ALL MATERIALS, EQUIPMENT, METHODS, LABOR, ETC. NOT INDICATED ON HEREIN, BUT REQUIRED FOR A COMPLETE INSTALLATION AND FULL OPERATION OF THAT TO BE "IMPLIED" AND SHALL BE FURNISHED BY THE CONTRACTOR AT NO ADDITIONAL COST. QUESTIONS REGARDING SCOPE OF CONTRACTOR RESPONSIBILITY SHALL BE BROUGHT TO THE DESIGN PROFESSIONAL PRIOR TO SUBMITTING A BID.</p>	<p>911 Auto Dialer Push Button 120V CONNECTION TO 911 AUTO DIALER. USE 14/2 WIRE. DIALER LOCATED DOWN NEAREST FULL FLOOR.</p>	<p>9. COORDINATE WITH FRANCHISEES LOW VOLTAGE REPRESENTATIVE FOR TELE/DATA WIRING CONNECTIONS BETWEEN THE INCOMING EQUIPMENT BOARD AND THE NERVE CENTER. SEE DETAIL 3/E2.0.</p>
<p>C. ALL WORK SHALL BE CONSTRUCTED IN CONFORMANCE WITH THE 2018 NATIONAL ELECTRICAL CODE AND ANYTIME FITNESS DESIGN COMPLIANCE PAMPHLET, LATEST RELEASE.</p>	<p>208V, 60A/3P Non-Fused Disconnect Switch (42"x16") 3/4" Fire Retardant Rated Plywood Backboard Power Connection To Recirculation Pump</p>	<p>10. LOCATE AND MOUNT 208V, 60A/3P NON-FUSED DISCONNECT SWITCH ON THE WALL. CONNECT WATER HEATER COMPLETE AND POWER TO RECIRCULATION PUMP. PROVIDE ALUMINUM RACEWAY, WIREMOLD ALA 3800 SERIES OR EQUAL TO CARDIO EQ.</p>
<p>D. REFER TO ARCHITECTURAL FINISH PLANS FOR REGARDING OUTLET AND SWITCH COVER PLATES.</p>	<p>20A Duplex Receptacle 4" Square Mud Ring 24" CAT5 Whip Coiled Up</p>	<p>11. MOUNT RECEPTACLE SERVING MONITOR CONCEALED BEHIND MONITOR. COORDINATE WITH MONITOR ELEVATIONS.</p>
<p>E. FIRE ALARM SYSTEM, IF REQUIRED, SHALL BE INSTALLED BY A LICENSED FIRE PROTECTION CONTRACTOR. SEPARATE PERMIT.</p>	<p>CAT5 Connection Quadruplex Receptacle</p>	<p>12. LOCATE POWER AND LOW VOLTAGE TRANSFORMER FOR ANYTIME FITNESS LIT MONOGRAM SIGN CONCEALED ABOVE OFFICE CEILING SPACE. CONNECT TO LIT MONOGRAM WALL. REFER TO ARCHITECTURAL DRAWINGS FOR FURTHER DETAILS.</p>
<p>F. WHERE APPLICABLE, ALL ELECTRICAL OUTLET BOXES, AND CONDUIT PENETRATIONS IN SOFFITS, SHALL BE INSTALLED WITH SOUND BLOCKING PUTTY AND ARCHITECTURAL WALL TYPES.</p>	<p>120V Power Connection 120V, 100A/3P, FIRE RETARDANT RATED PLYWOOD</p>	<p>13. CONNECT OFFICE RECEPTACLE TO OCCUPANCY SENSOR SWITCH IN ACCORDANCE WITH 2021 IECC.</p>
<p>G. COORDINATE LOW VOLTAGE ROUGH-IN, WIRING, TERMINATION RESPONSIBILITIES WITH OWNERSHIP REPRESENTATIVE PRIOR TO BID. LOW VOLTS INCLUDE BUT ARE NOT LIMITED TO TELEPHONE, CONTROL, CCTV, CATV, SOUND MASKING AND</p>	<p>Aluminum Raceway, Wiremold ALA 3800 Series 3/4" C, 3#10, 3#10N, #10G 1" C, 3#4, #8G</p>	<p>14. PROVIDE A 208V, 100A/3P, NON-FUSED DISCONNECT SWITCH IN A NEMA-3R ENCLOSURE TO SERVE NEW ROOFTOP UNIT. CONFIRM EQUIPMENT REQUIREMENTS WITH FINAL EQUIPMENT.</p>
	<p>Low Voltage Transformer Junction Box</p>	<p>15. PROVIDE (3) BRANCH CIRCUITS TO JBOX FOR FUTURE CARDIO EQUIPMENT.</p>
		<p>16. PROVIDE A 208V, 100A/3P, NON-FUSED DISCONNECT SWITCH IN A NEMA-3R ENCLOSURE TO SERVE NEW ROOFTOP UNIT. CONFIRM EQUIPMENT REQUIREMENTS WITH FINAL EQUIPMENT.</p>
		<p>17. PROVIDE WEATHERPROOF GFCI RECEPTACLE AT NEW RTU FOR HVAC SERVICING.</p>
		<p>18. PROVIDE DEDICATED 120V CIRCUIT FED FROM A RED LOCKABLE CIRCUIT BREAKER FOR FIRE ALARM SMOKE DUCT DETECTORS IN RTU DUCTWORK. COORDINATE WITH THE DELEGATED DESIGN FIRE PROTECTION PROFESSIONAL AND PROVIDE AND INSTALL.</p>

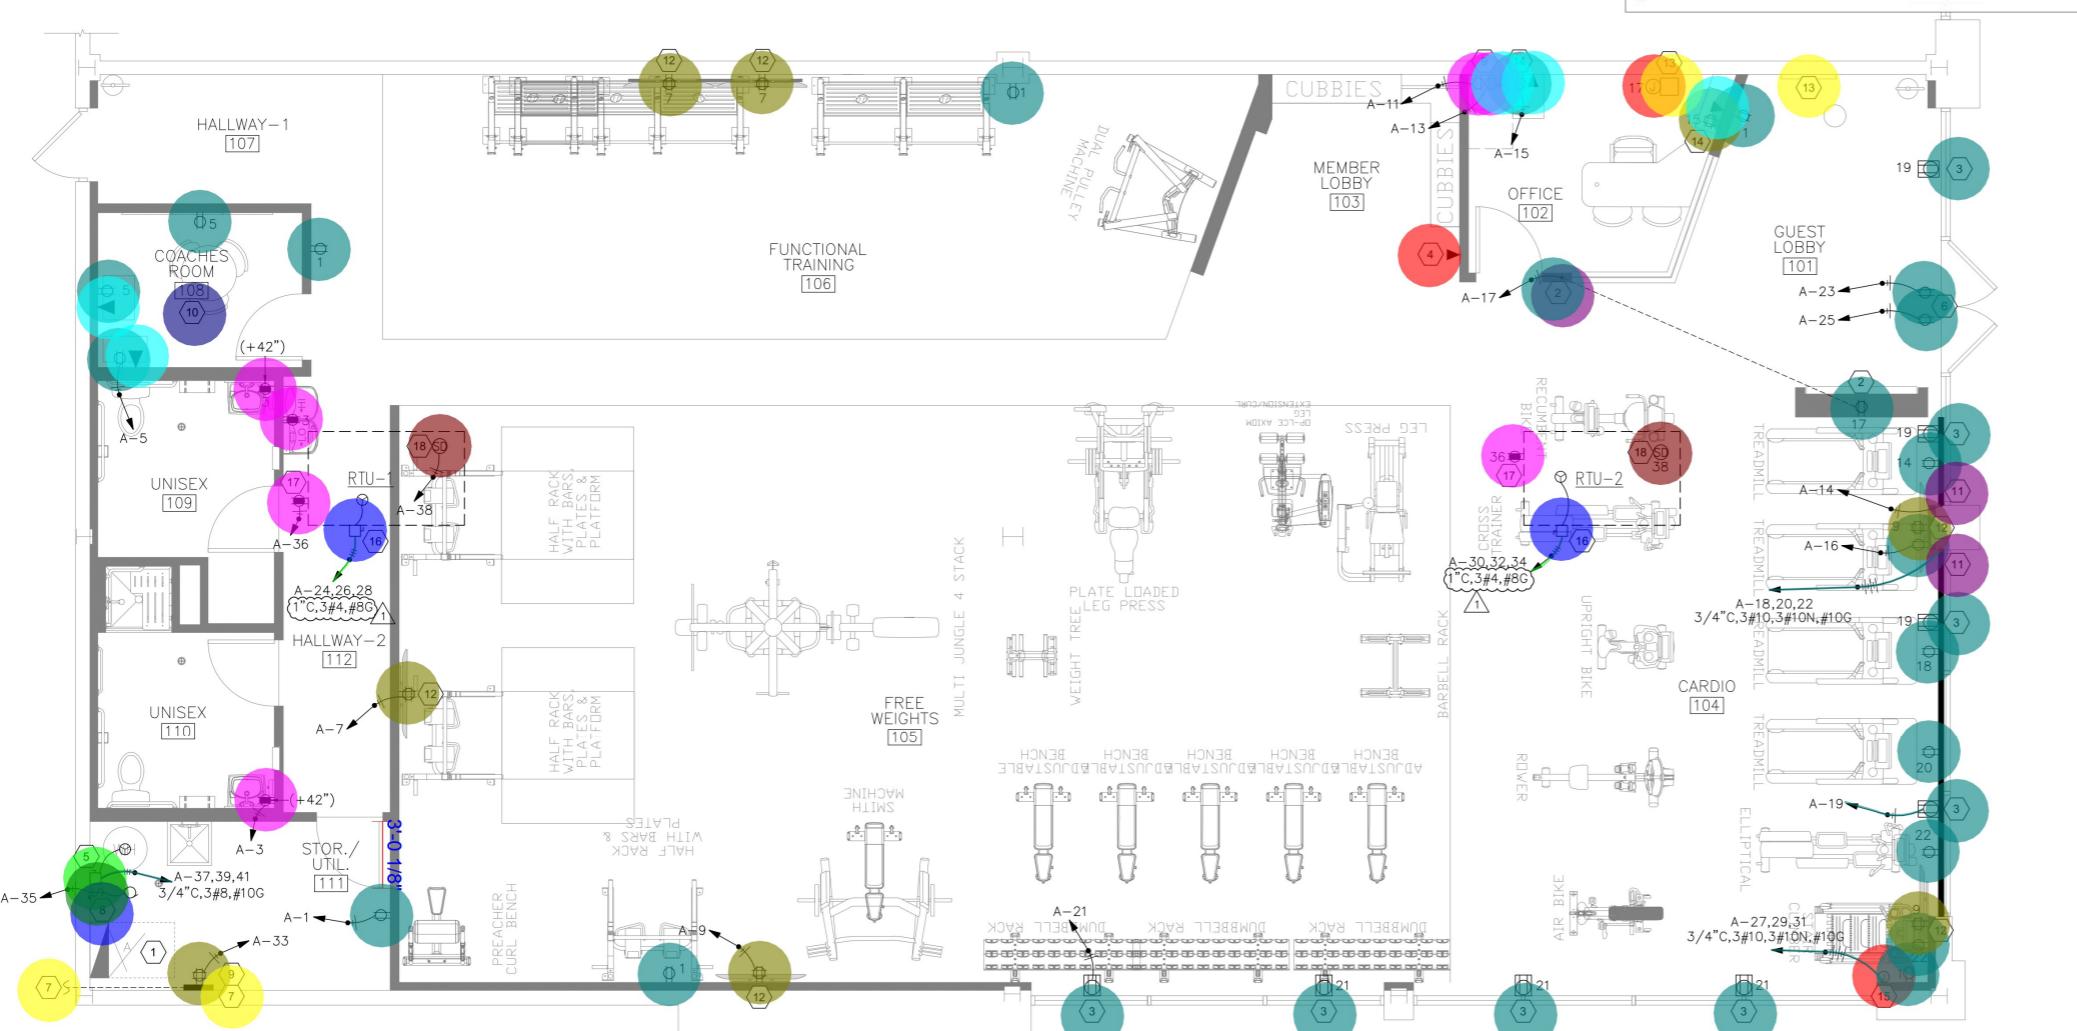

1  
E2.0 POWER AND SYSTEMS FLOOR PLAN  
SCALE: 1/4" = 1'-0"

2 LIGHT BOX POWER ROUGH-IN  
E2.0 SCALE: NO SCALE

The seal is a semi-circular border with a dotted line pattern. Inside the border, the words "STATE OF FLORIDA" are written in a serif font, and "PROFESSIONAL ENGINEER" is written below it in a larger, bold, sans-serif font.

The logo for Anytime Fitness, featuring the brand name in a bold, black, sans-serif font above a stylized purple human figure icon.

WINCHESTER CENTER  
11 WINCHESTER TRAIL  
BUILDING 100 SUITE 100  
NAPLES, FL 34120

## REVISI覩NS


REV.	DATE	ISSUE
1	06/11/25	REVISION 1

DATE: 05.27.25  
DRAWN BY: MHK  
CHECKED BY: MHK

## ELECTRICAL FLOOR PLAN


E2.0



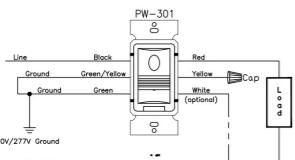

TYPICAL INFRARED WALL SWITCH WIRING DIAGRAM  
NOT TO SCALE

- 20/1 Circuit Breaker
- 50/3 Circuit Breaker
- 70/3 Circuit Breaker
- 20/1 Red Lockable Circuit Breaker

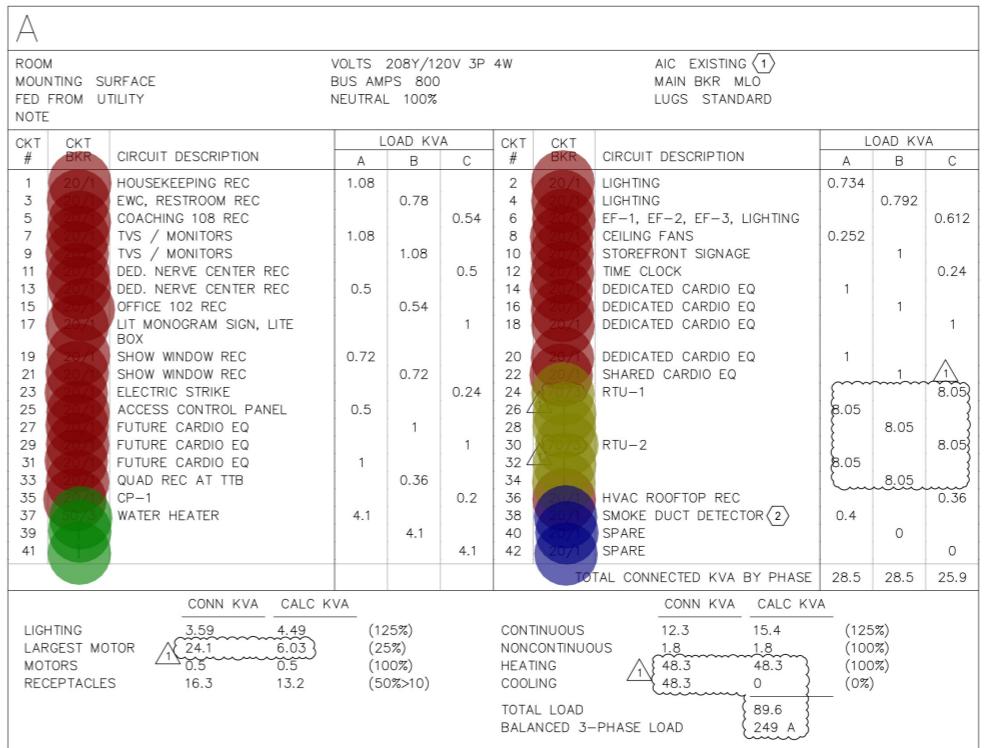

architecture | engineering  
1515 DES PERES ROAD, STE 200  
SAINT LOUIS, MISSOURI 63131  
PHONE | 314-997-6111 FAX | 314-997-8066

## CONSULTANT



SEAL



WINCHESTER CENTER  
33851 WINCHESTER TRAIL  
BUILDING 100 SUITE 100  
NAPLES, FL 34120

## REVISIONS

REV.	DATE	ISSUE
1	06/11/25	REVISION 1

DATE: 05.27.25  
DRAWN BY: MHK  
CHECKED BY: MHK  
PROJECT NUMBER: 756368

# ELECTRICAL DETAILS AND SCHEDULES

# E4.0